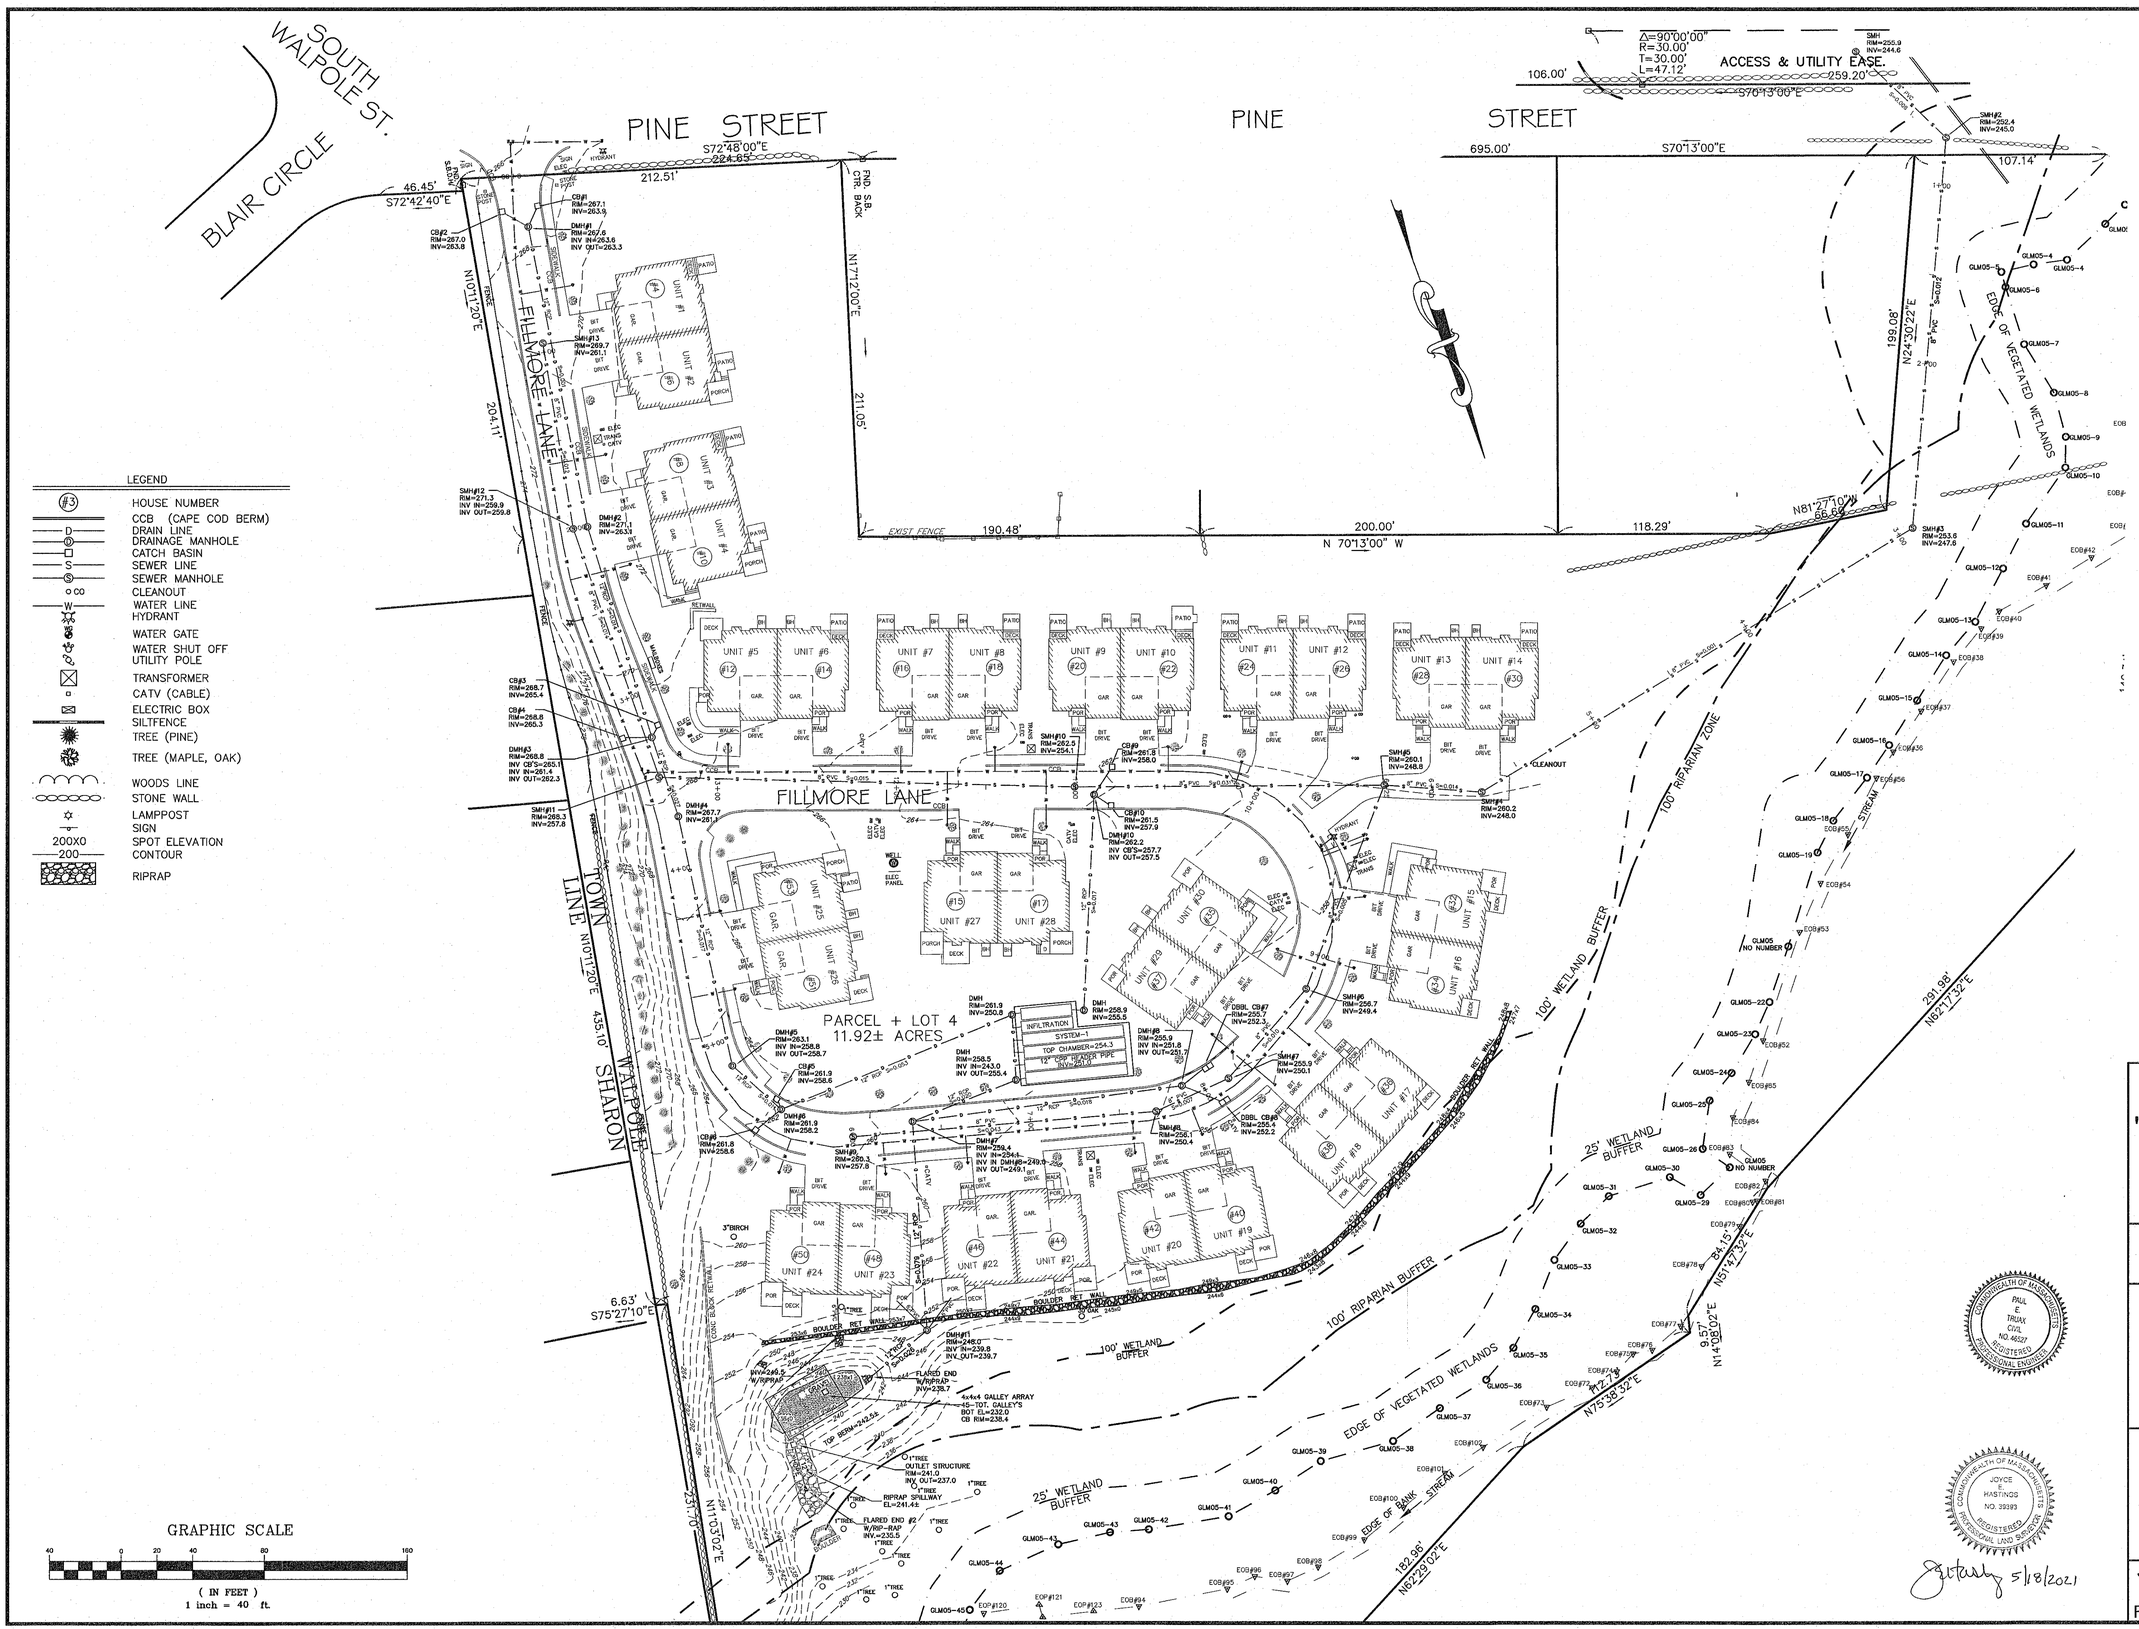

AS-BUILT PLAN "BROOKSIDE VILLAGE" FILLMORE LANE WALPOLE, MA

MAY 14, 2021

PREPARED FOR:

BROOKSIDE VILLAGE WALPOLE, LLC

1 GOLDEN COURT
WESTBOROUGH, MA

GLM Engineering Consultants, Inc.
19 EXCHANGE STREET
HOLLISTON, MA 01746
P: 508-429-1100 F: 508-429-7160
www.GLMengineering.com

COMMONWEALTH OF MASSACHUSETTS PAUL E. TRUAX CIVIL NO. 46537 REGISTERED PROFESSIONAL ENGINEER

COMMONWEALTH OF MASSACHUSETTS JOYCE A. HASTINGS NO. 39393 REGISTERED PROFESSIONAL LAND SURVEYOR

5/18/2021

JOB NO.: 10888-ROAD ASB	SHEET 1 OF 1	PLAN NO. 27,492